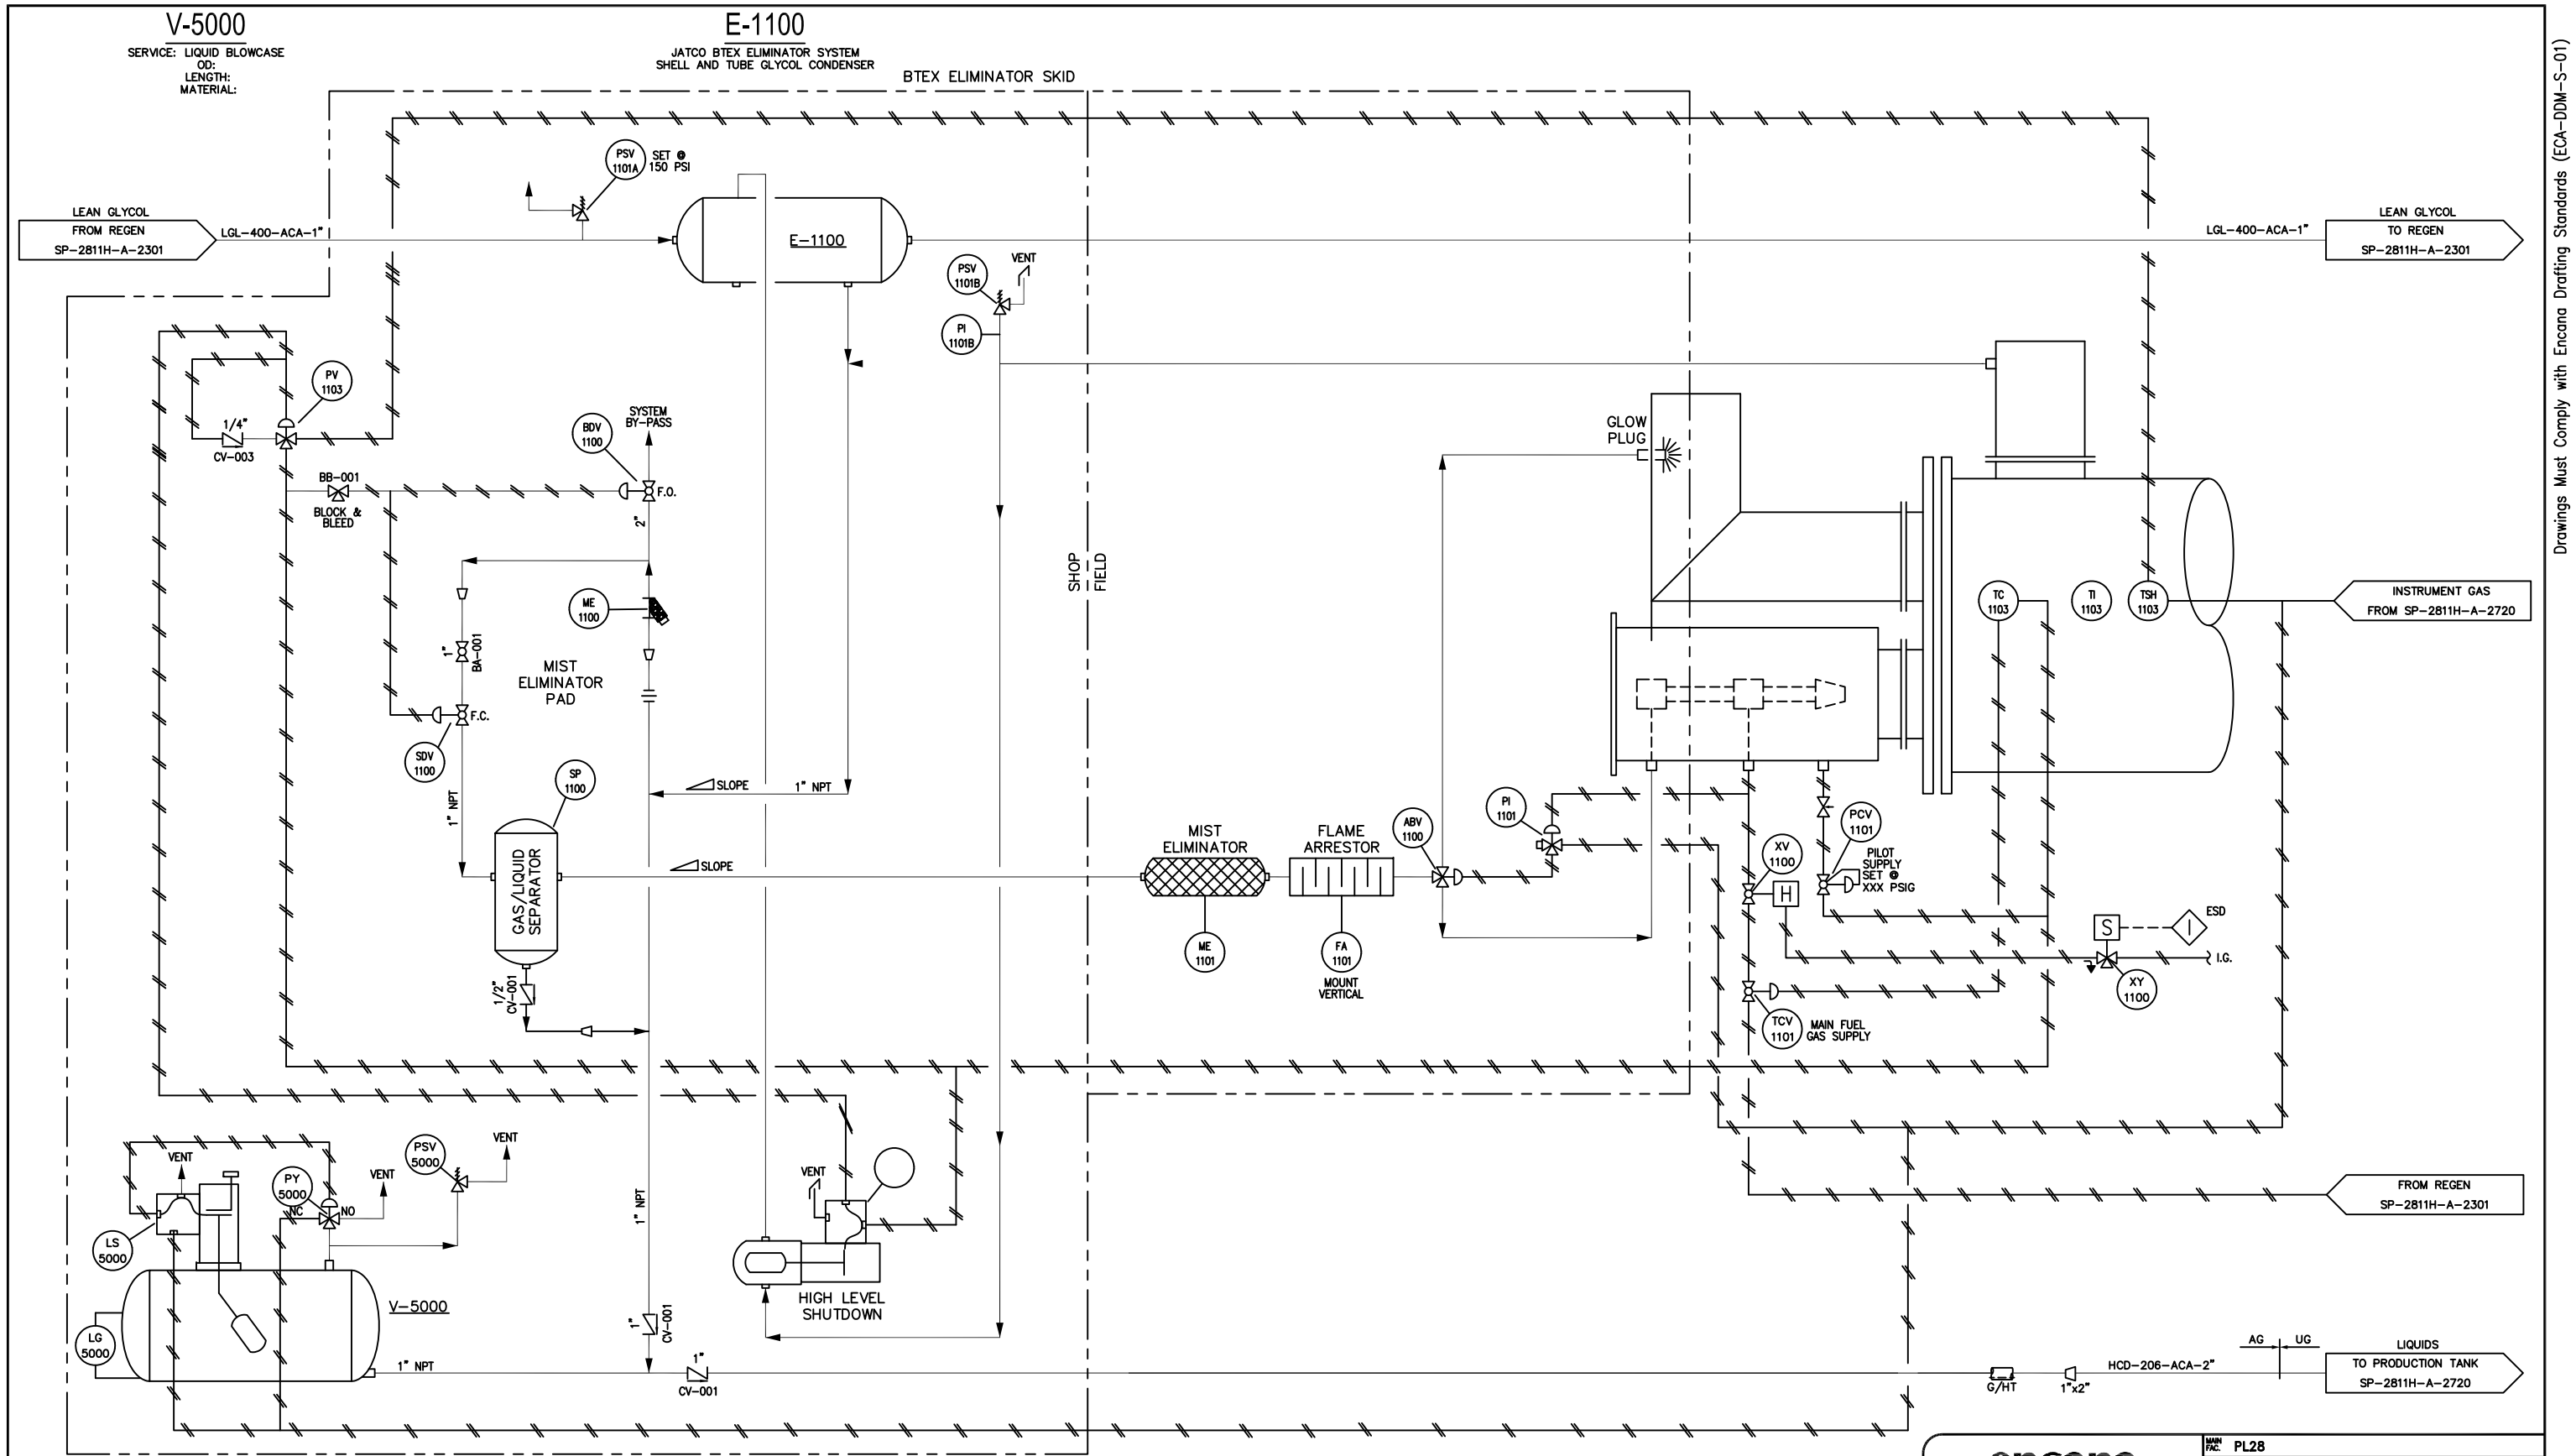

Drawings Must Comply with Encana Drafting Standards (ECA-DDM-S-01)

REFERENCE DRAWINGS	DWG. NO.

CAUTION : READ BEFORE EXCAVATION

ALL EXCAVATIONS MUST BE CARRIED OUT AS PER "ENCANA'S GROUND DISTURBANCE PRACTICE"

NO.	DATE (YYYY-MM-DD)	PROJECT DESCRIPTION	PROJ.	AFE	EPCM Co.	EPCM No.	APPD.

REV. NUMBER	ISSUE STAGE	DATE (YYYY-MM-DD)	BY	CHKD.	APPD.
	Prelim (A)				
	Bid (B)				
	Constr. (C)				
	As-built (D)	2013-01-02	ACS		

PERMIT STAMP | ENGINEER'S STAMP

PERMIT STAMP AND PROFESSIONAL STAMP AFFIXED ABOVE SHALL APPLY ONLY TO REV(s)

encana natural gas

MAIN FAC. PL28
MAIN LSD. 28-9S-97W
FAC. TYPE WELLSITE
SITE LSD. 28-9S-97W
SCALE
EPCM No.
EPCM Co.

TITLE PIPING AND INSTRUMENTATION DIAGRAM JATCO SKID

AREA SOUTH PICEANCE | CLASS A | FILE NO. SP-2811H-A-2302

PLOTTED: 01/14/2013 7:36:16 AM BY: STRATMAN, ASHLEY C.
LAST SAVED: 01/02/2013 12:42:20 PM BY: ASTRATMA

T-001GUNG (ENCANA D Size Title Block) v3