MSSU 31-3
AS-BUILT FLOWLINE EXHIBIT

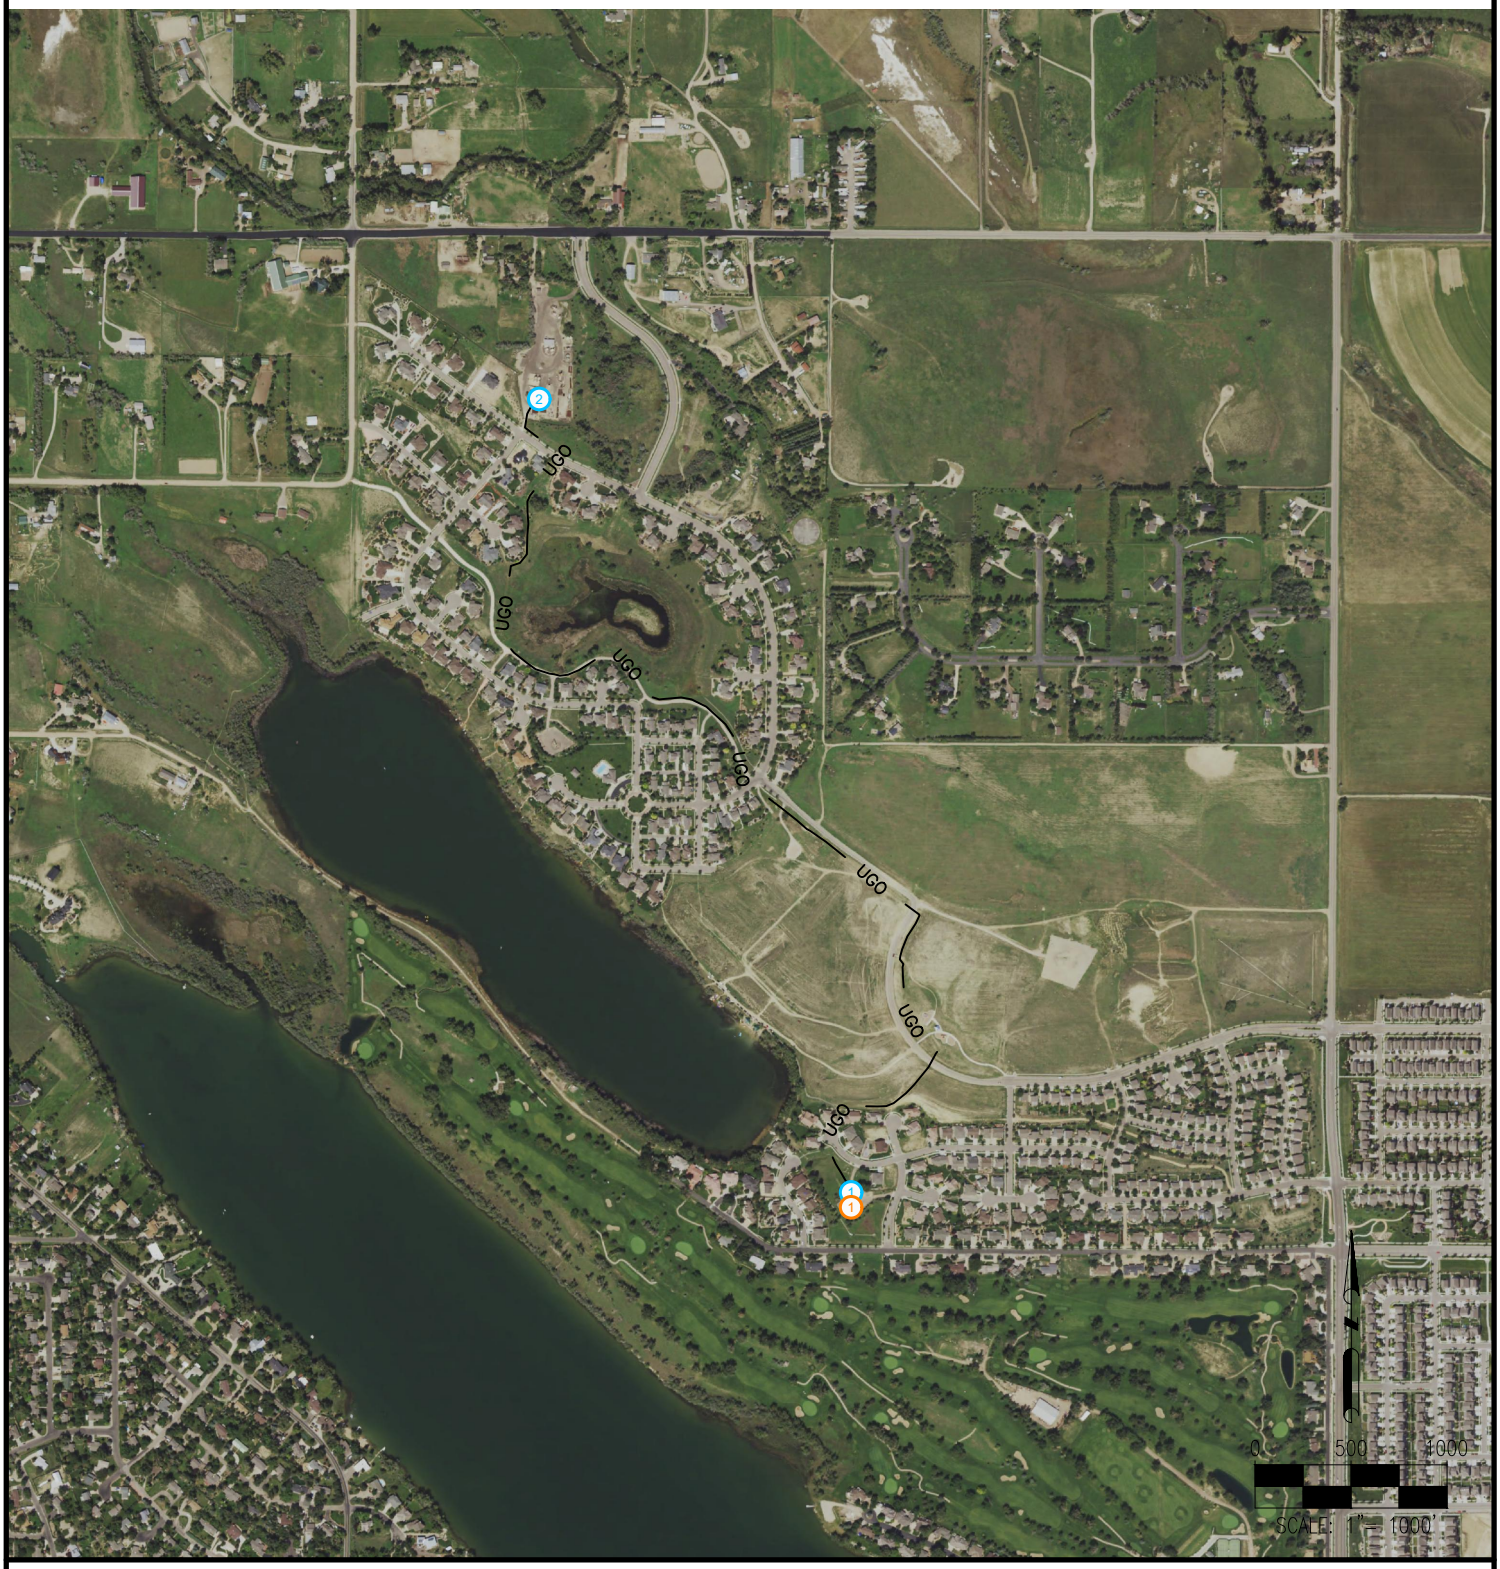

LEGEND: —— UGO —— = FLOWLINE (1) MSSU 31-3 WELLHEAD (1) MSSU 31-3 RISER AT WELLHEAD (2) MSSU 31-3 RISER AT SEPARATOR

LINE STATUS: IJ

ASCENT GEOMATICS SOLUTIONS
8620 Wolff Court
Westminster, CO 80031
(303) 928-7128
www.ascentgeomatics.com

FIELD DATE:	09-23-10
DRAWING DATE:	10-31-19
BY:	TLJ
CHECKED:	SJH

SURFACE LOCATION:
SEC. 30, T8N, R68W, 6TH P.M.
LARIMER COUNTY, COLORADO

PREPARED FOR:
Prospect Energy, LLC