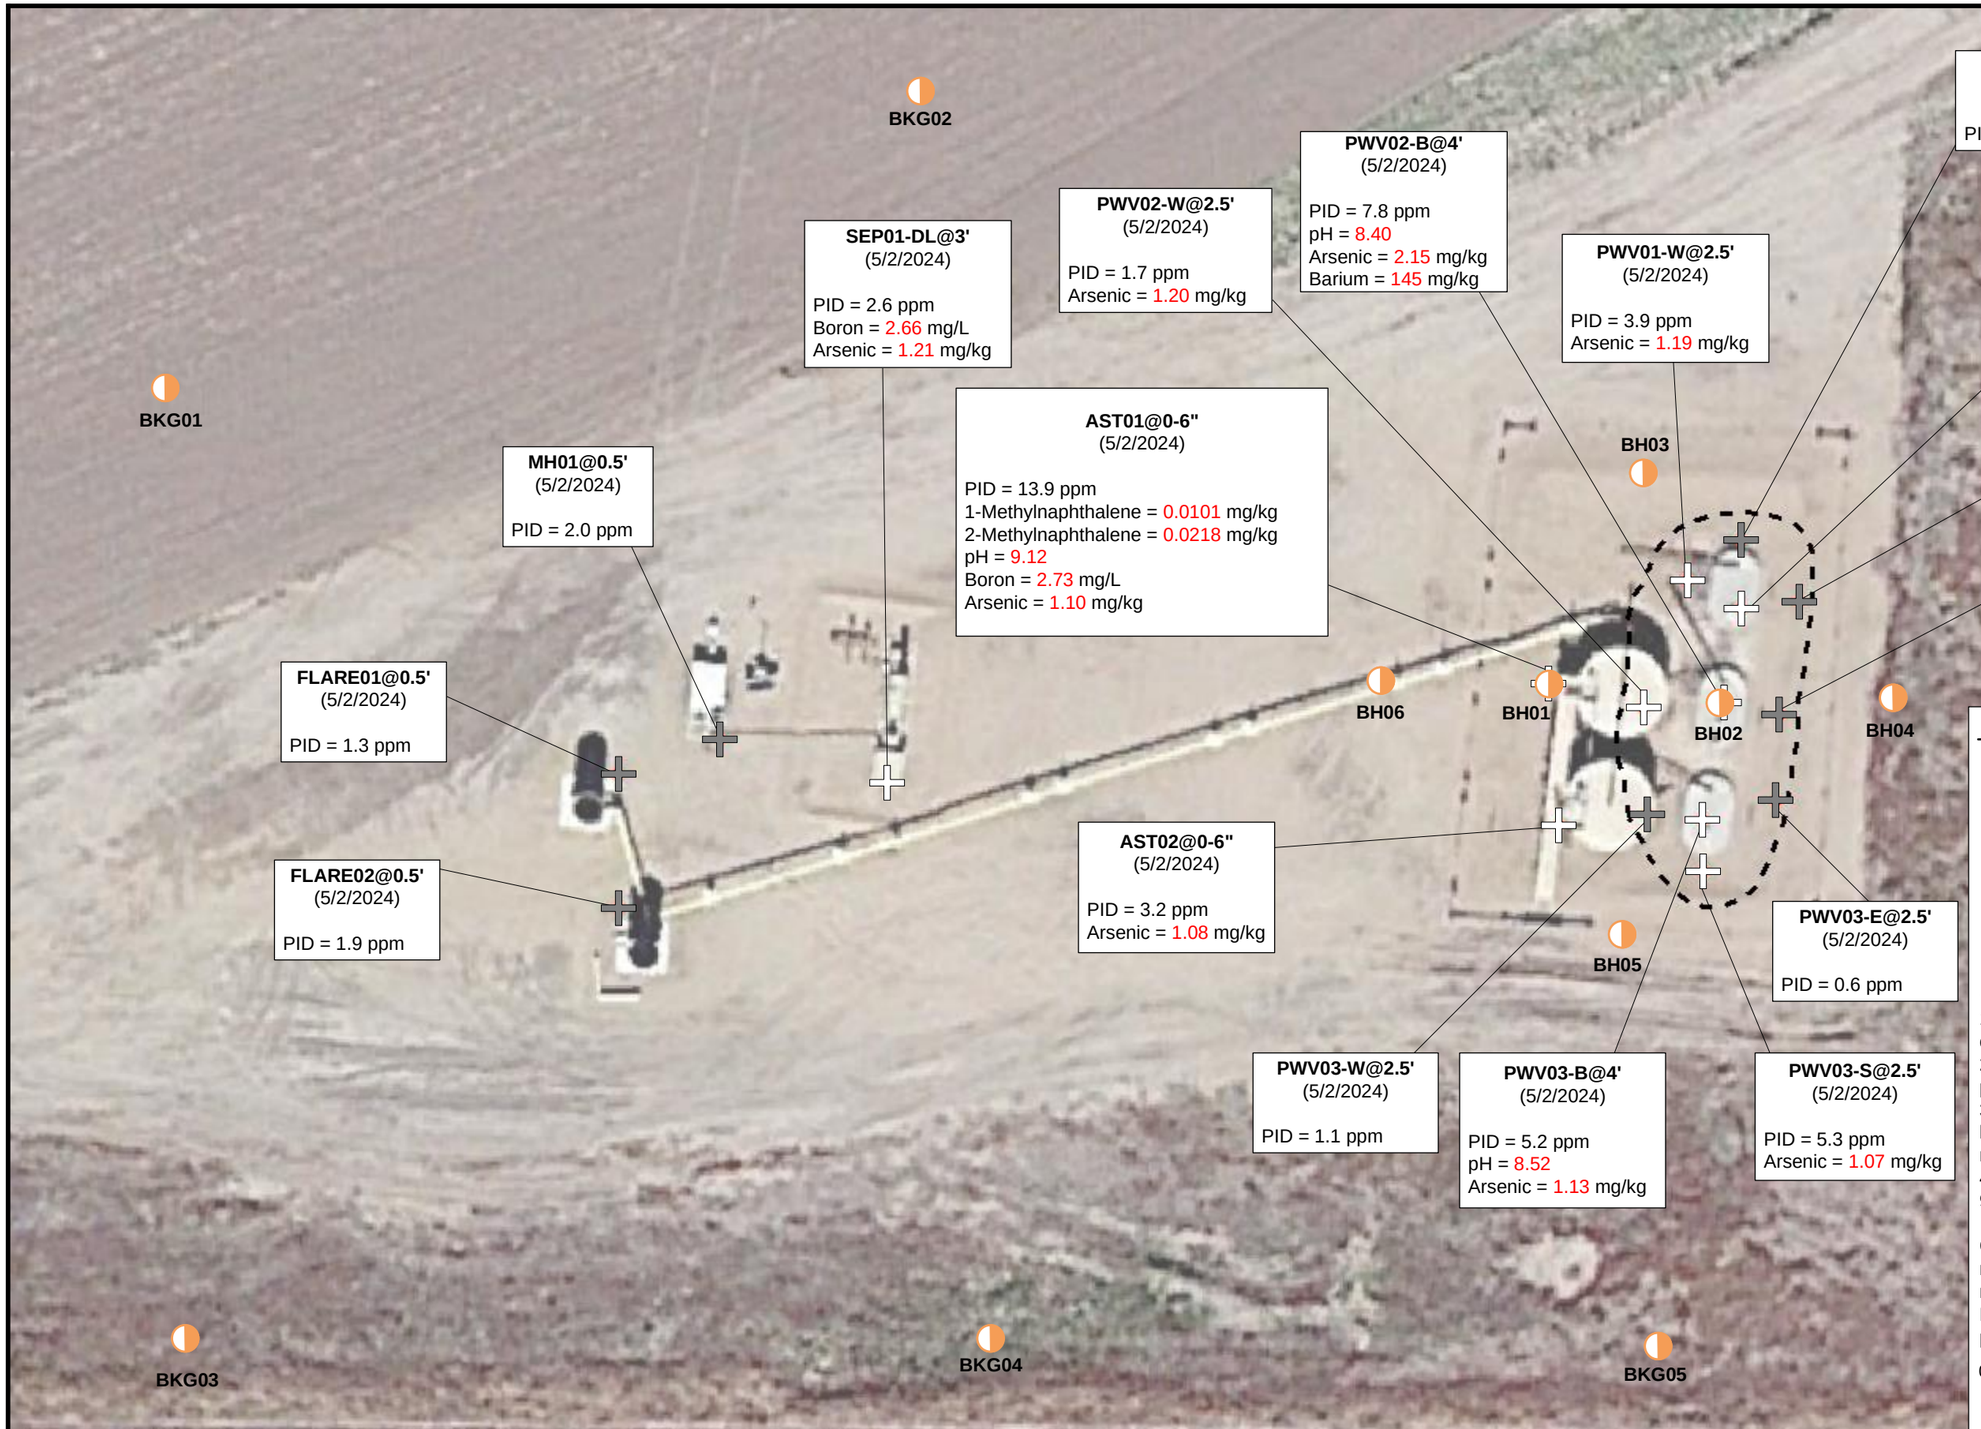

Legend

- Proposed Soil Boring Location
- Excavation Extent (Collected via Trimble GPS)
- Soil Sample Location – Field Screen (Collected via Trimble GPS)
- Soil Sample Location – Lab Analyzed (Collected via Trimble GPS)

Notes

1) All locations are approximate unless otherwise noted.
2) Buried infrastructure has been spatially projected.
3) Analytical results below laboratory detection limits or within compliance of ECMC Table 915-1 not shown.
4) Concentration in exceedance of ECMC Table 915-1 soil standards indicated in RED.

GPS – Global Positioning System
mg/L – Milligrams per liter
mg/kg – Milligrams per kilogram
PID – Photoionization Detector
ppm – Parts per million

0 ft. 20 ft. 40 ft.

N

Image Source: Google Earth; Google 2020

DATE:	06/07/2024
DESIGNED BY:	JW
DRAWN BY:	EH

TASMAN GEOSCIENCES

Tasman Geosciences, Inc.
6855 W 119th Avenue
Broomfield, CO 80020

Noble Energy, Inc. – DJ Basin
Wolfe USX CC07-16 Facility
SESW, Section 7, Township 4 North, Range 63 West
Weld County, Colorado

Proposed Soil Boring Locations Map