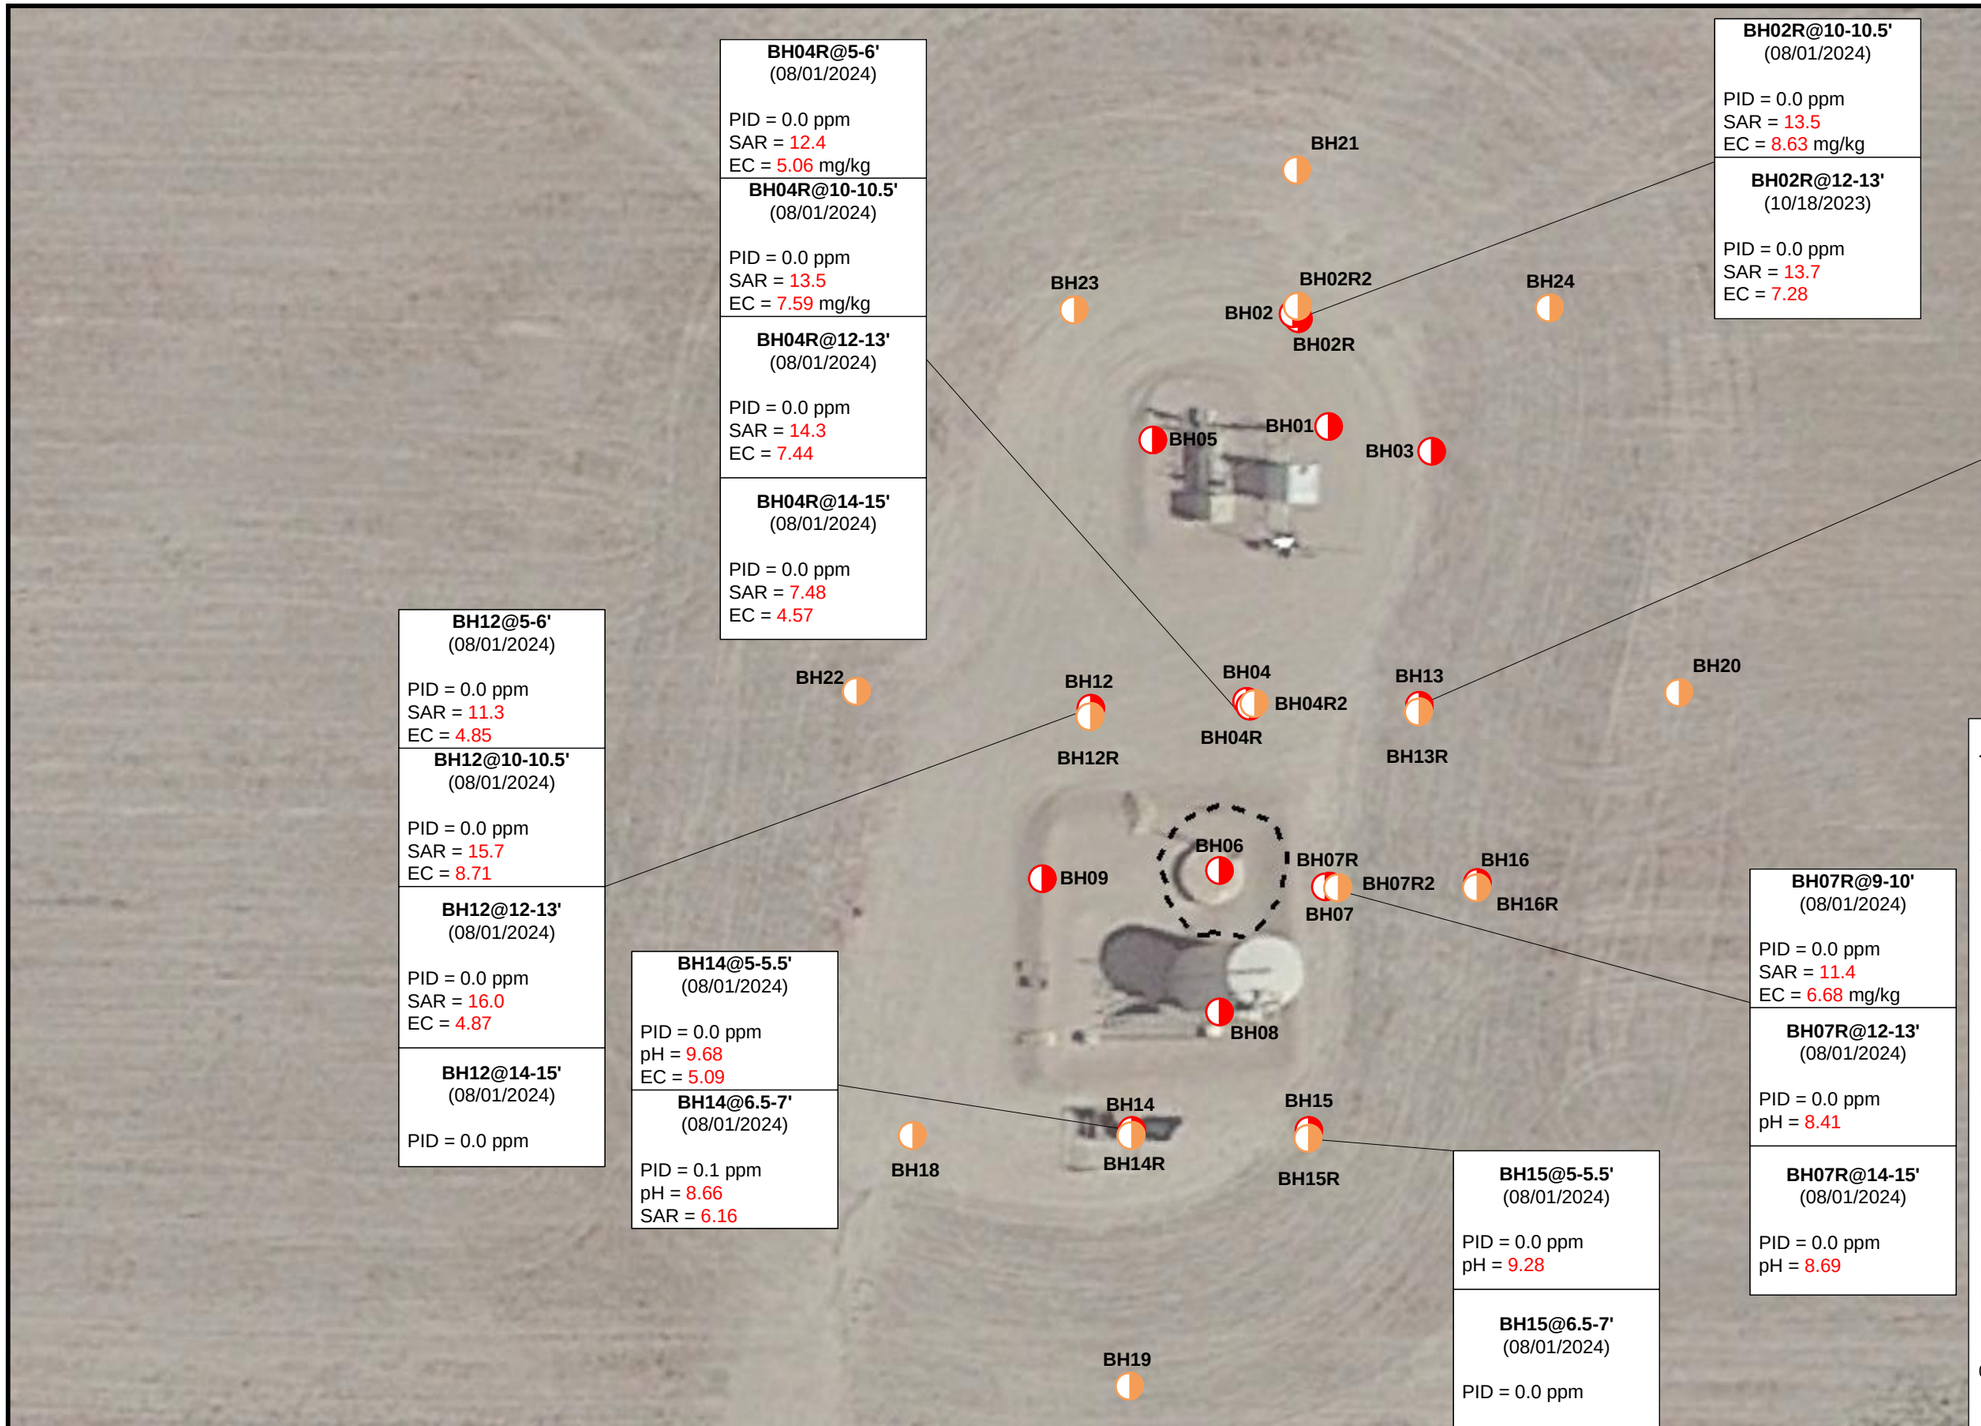


**BH04R@5-6'**
(08/01/2024)

PID = 0.0 ppm
SAR = 12.4
EC = 5.06 mg/kg

**BH04R@10-10.5'**
(08/01/2024)

PID = 0.0 ppm
SAR = 13.5
EC = 7.59 mg/kg

**BH04R@12-13'**
(08/01/2024)

PID = 0.0 ppm
SAR = 14.3
EC = 7.44

**BH04R@14-15'**
(08/01/2024)

PID = 0.0 ppm
SAR = 7.48
EC = 4.57

**BH02R@10-10.5'**
(08/01/2024)

PID = 0.0 ppm
SAR = 13.5
EC = 8.63 mg/kg

**BH02R@12-13'**
(10/18/2023)

PID = 0.0 ppm
SAR = 13.7
EC = 7.28

**BH13@5-6'**
(08/01/2024)

PID = 0.0 ppm
SAR = 7.98
EC = 5.09

**BH13@9-10'**
(08/01/2024)

PID = 0.0 ppm
SAR = 14.8
EC = 7.96

**BH13@12-13'**
(08/01/2024)

PID = 0.0 ppm
SAR = 13.7
EC = 6.98

**BH13@14-15'**
(08/01/2024)

PID = 0.0 ppm
SAR = 15.3
EC = 6.74

**BH12@5-6'**
(08/01/2024)

PID = 0.0 ppm
SAR = 11.3
EC = 4.85

**BH12@10-10.5'**
(08/01/2024)

PID = 0.0 ppm
SAR = 15.7
EC = 8.71

**BH12@12-13'**
(08/01/2024)

PID = 0.0 ppm
SAR = 16.0
EC = 4.87

**BH12@14-15'**
(08/01/2024)

PID = 0.0 ppm

**BH14@5-5.5'**
(08/01/2024)

PID = 0.0 ppm
pH = 9.68
EC = 5.09

**BH14@6.5-7'**
(08/01/2024)

PID = 0.1 ppm
pH = 8.66
SAR = 6.16

**BH07R@9-10'**
(08/01/2024)

PID = 0.0 ppm
SAR = 11.4
EC = 6.68 mg/kg

**BH07R@12-13'**
(08/01/2024)

PID = 0.0 ppm
pH = 8.41

**BH07R@14-15'**
(08/01/2024)

PID = 0.0 ppm
pH = 8.69

**BH15@5-5.5'**
(08/01/2024)

PID = 0.0 ppm
pH = 9.28

**BH15@6.5-7'**
(08/01/2024)

PID = 0.0 ppm

## Legend

Proposed Soil Boring Location

Excavation Extent
(Collected via Trimble GPS)

Assessment Location (Collected via Trimble GPS)

## Notes

1) All locations are approximate unless otherwise noted.
2) Site Infrastructure has been removed; shown for illustrative purposes only.
3) Analytical results below laboratory detection limits or within compliance of ECMC Table 915-1 not shown.
4) Concentration in exceedance of ECMC Table 915-1 soil standards indicated in RED.

GPS – Global Positioning System
mg/kg – Milligrams per kilogram
mmhos/cm – Millimhos per centimeter
PID – Photoionization Detector
ppm – parts per million
EC – Electrical Conductivity
SAR – Sodium Adsorption Ratio

0 ft. 25 ft. 50 ft.

N

Image Source: Google Earth; Google 2020

| | |
|---|---|
| DATE: | 09/24/2024 |
| DESIGNED BY: | J. Whritenour |
| DRAWN BY: | L. Moran |

TASMAN

**Tasman, Inc.**
**6855 W 119th Avenue**
**Broomfield, CO 80020**

**Noble Energy, Inc. – DJ Basin**
**BRNAK 34-28 Facility**
SWSE, Section 28, Township 2 North, Range 64 West
Weld County, Colorado

Soil Boring
Locations Map