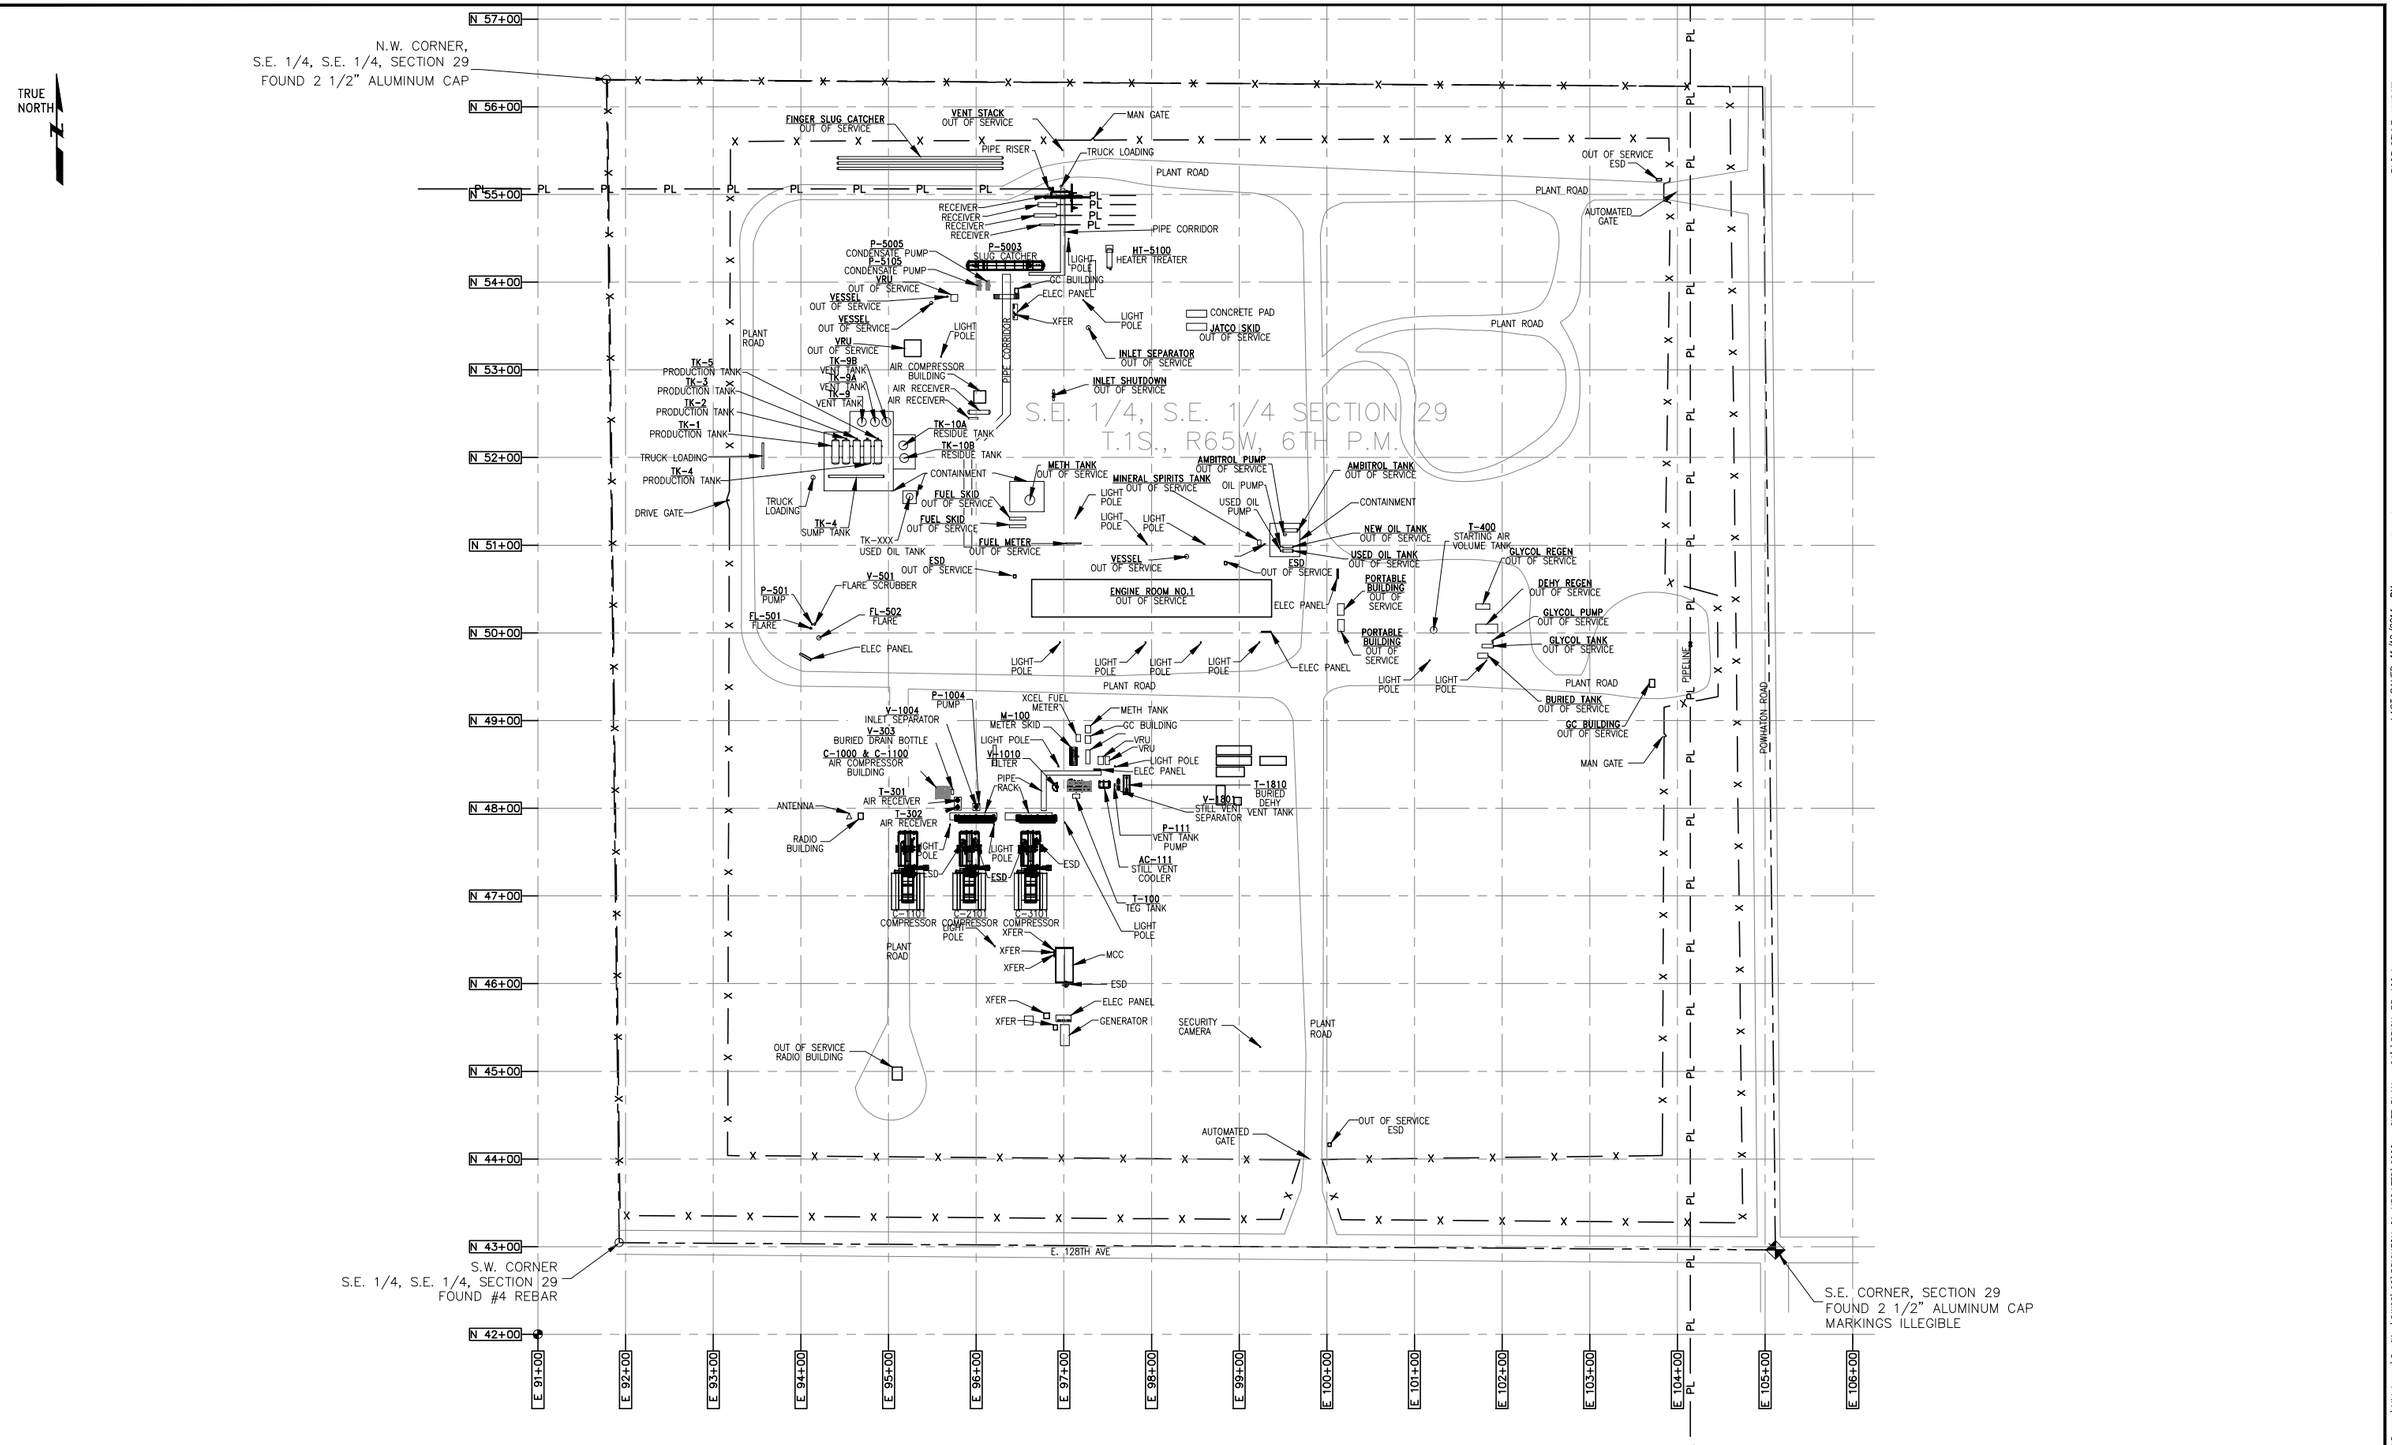

THIS DRAWING AND THE DESIGN IT COVERS ARE CONFIDENTIAL AND REMAIN THE PROPERTY OF ANADARKO PETROLEUM CORPORATION AND SHALL NOT BE DISCLOSED TO OTHERS OR REPRODUCED IN ANY MANNER OR USED FOR ANY PURPOSE WHATSOEVER EXCEPT BY WRITTEN PERMISSION BY THE OWNER.

NOTES:

REFERENCE DRAWINGS	
DWG. NO.	TITLE

REVISIONS					
NO.	DESCRIPTION	BY	DATE	CHK.	DATE	APPR.	DATE
1	AS-BUILT PLOT PLAN	CON	4/21/14	NJL	4/21/14		

Anadarko Petroleum Corporation

BRIGHTON COMPRESSOR STATION

PIPING
SITE PLAN

DRAWN BY:	CREATION DATE:	AFE No.: 380767
APPROVED: –	APPR. DATE:	
SCALE: 1" = 800'-0"	DWG. No.: BRIGH-PP-100.DWG	SHEET No. – OF – 3

FILE LOCATION: L:\Shared Data\Denver\Midstream\Drafting\DWGS\CO\BRIGHTON_01-UPDATED\2000 - SITE PLAN - GA's\BRIGH-PP-100.dwg

LAST SAVED: 11/19/2014 BY: Funk, Justin (Denver)

PLOT STYLE: 11017.CTB